

EXHIBIT B UTILITY DESIGN SHEET**PROJECT IM 0252-423**

Utility Co. #

Conflict #

G-01

Utility Owner: Colorado Springs Utilities Gas ☒ Public ☐ Private**SECTION TO BE COMPLETED PRIOR TO NEGOTIATION MEETING****Existing Condition** See Utility Map for conflicts to G-01

- General Location _____
- Utility type: ☐ Electric ☒ Gas ☐ Communications ☐ Water ☐ Sanitary ☐ Cable TV ☐ Irr. Canal
☐ Other _____
- Location by: ☐ Utility plat maps; Field located and surveyed: ☒ Yes ☐ No; Pothole: ☐ Yes ☐ No
If pothole, # _____ from: ☐ CDOT pothole or ☐ DBC pothole HCL used: _____
Station: 115+ to Station: 115+ Dist. from HCL: _____ Rt. / Lt. Lt
- Utility size & type of materials: 4" service line on Abbott Lane at I-25.
- Environmental Concerns: _____
- Encased: ☒ No ☐ Yes, if so size & material: _____
This section completed by DBC Rep.: _____ Date: _____

SECTION TO BE COMPLETED AT NEGOTIATION MEETING**Proposed Resolution**

- Recommendation: ☐ left alone ☐ modified ☐ removed ☐ relocated ☐ upgraded ☐ abandoned in place
Conflict with: _____
- This utility may be modified/relocated to: _____
Station: _____ to Station: _____ Dist. from HCL: _____ Rt./Lt. _____
- Utility in: ☐ CDOT ROW ☐ other public ROW ☐ Easement (attach copy) ☐ other _____
- Who will do the Utility Relocation Plan: ☐ Utility Company (UC) ☐ Design/Build Contractor (DBC)
- Who will do the construction: ☐ Utility Company (UC) ☐ Design/Build Contractor (DBC)
- UC to perform inspection? ☐ No ☐ Yes, if so conditions: _____
- Number of days required for prior notification by DBC for construction by UC: _____ days
- Number of days required by UC or DBC to complete Utility Relocation Plan: _____ days; Construction: _____ days.
- Any construction details unique to this location? ☐ No ☐ Yes, if yes describe: _____
- Utility can be disconnected for: _____ days/hours.
- Other proposed action: _____
- Contractor Drawings confirming conflict must be attached
This section completed by: Utility Co. _____ Date: _____ DBC _____ Date: _____

EXHIBIT B UTILITY DESIGN SHEET**PROJECT IM 0252-423**

Utility Co. #

Conflict #

G-02

Utility Owner: Colorado Springs Utilities Gas ☒ Public ☐ Private**SECTION TO BE COMPLETED PRIOR TO NEGOTIATION MEETING****Existing Condition** See Utility Map for conflicts to G-02

1. General Location _____
2. Utility type: ☐ Electric ☒ Gas ☐ Communications ☐ Water ☐ Sanitary ☐ Cable TV ☐ Irr. Canal
☐ Other _____
3. Location by: ☐ Utility plat maps; Field located and surveyed: ☒ Yes ☐ No; Pothole: ☐ Yes ☐ No
If pothole, # _____ from: ☐ CDOT pothole or ☐ DBC pothole HCL used: _____
Station: 115+ to Station: 145+ Dist. from HCL: _____ Rt. / Lt. Lt
4. Utility size & type of materials: 8", 150# line crossing I-25 at Midland.
5. Environmental Concerns: _____
6. Encased: ☐ No ☒ Yes, if so size & material: 12" Steel ?
This section completed by DBC Rep.: _____ Date: _____

SECTION TO BE COMPLETED AT NEGOTIATION MEETING**Proposed Resolution**

1. Recommendation: ☐ left alone ☐ modified ☐ removed ☐ relocated ☐ upgraded ☐ abandoned in place
Conflict with: _____
2. This utility may be modified/relocated to: _____
Station: _____ to Station: _____ Dist. from HCL: _____ Rt./Lt. _____
3. Utility in: ☐ CDOT ROW ☐ other public ROW ☐ Easement (attach copy) ☐ other _____
4. Who will do the Utility Relocation Plan: ☐ Utility Company (UC) ☐ Design/Build Contractor (DBC)
5. Who will do the construction: ☐ Utility Company (UC) ☐ Design/Build Contractor (DBC)
6. UC to perform inspection? ☐ No ☐ Yes, if so conditions: _____
7. Number of days required for prior notification by DBC for construction by UC: _____ days
8. Number of days required by UC or DBC to complete Utility Relocation Plan: _____ days; Construction: _____ days.
9. Any construction details unique to this location? ☐ No ☐ Yes, if yes describe: _____
10. Utility can be disconnected for: _____ days/hours.
11. Other proposed action: _____
12. Contractor Drawings confirming conflict must be attached
This section completed by: Utility Co. _____ Date: _____ DBC _____ Date: _____

EXHIBIT B UTILITY DESIGN SHEET**PROJECT IM 0252-423**

Utility Co. #

Conflict #

G-03


Utility Owner: Colorado Springs Utilities Gas ☒ Public ☐ Private**SECTION TO BE COMPLETED PRIOR TO NEGOTIATION MEETING****Existing Condition** See Utility Map for conflicts to G-03

1. General Location _____
2. Utility type: ☐ Electric ☒ Gas ☐ Communications ☐ Water ☐ Sanitary ☐ Cable TV ☐ Irr. Canal
☐ Other _____
3. Location by: ☐ Utility plat maps; Field located and surveyed: ☒ Yes ☐ No; Pothole: ☐ Yes ☐ No
If pothole, # _____ from: ☐ CDOT pothole or ☐ DBC pothole HCL used: _____
Station: 139+ to Station: 141+ Dist. from HCL: _____ Rt. / Lt. _____
4. Utility size & type of materials: 4" service line from Colorado Ave. Down Walnut St. to Chucarras St.
5. Environmental Concerns: _____
6. Encased: ☒ No ☐ Yes, if so size & material: _____
This section completed by DBC Rep.: _____ Date: _____

SECTION TO BE COMPLETED AT NEGOTIATION MEETING**Proposed Resolution**

1. Recommendation: ☐ left alone ☐ modified ☐ removed ☐ relocated ☐ upgraded ☐ abandoned in place
Conflict with: _____
2. This utility may be modified/relocated to: _____
Station: _____ to Station: _____ Dist. from HCL: _____ Rt./Lt. _____
3. Utility in: ☐ CDOT ROW ☐ other public ROW ☐ Easement (attach copy) ☐ other _____
4. Who will do the Utility Relocation Plan: ☐ Utility Company (UC) ☐ Design/Build Contractor (DBC)
5. Who will do the construction: ☐ Utility Company (UC) ☐ Design/Build Contractor (DBC)
6. UC to perform inspection? ☐ No ☐ Yes, if so conditions: _____
7. Number of days required for prior notification by DBC for construction by UC: _____ days
8. Number of days required by UC or DBC to complete Utility Relocation Plan: _____ days; Construction: _____ days.
9. Any construction details unique to this location? ☐ No ☐ Yes, if yes describe: _____
10. Utility can be disconnected for: _____ days/hours.
11. Other proposed action: _____
12. Contractor Drawings confirming conflict must be attached
This section completed by: Utility Co. _____ Date: _____ DBC _____ Date: _____

PadillaK 2:00:26 PM pw:\\ABQPWINT01.wilsonco.com\\Wilson_Projects\\Documents\\8100-TRN\\CDDT\\13-100-312-01_125_Cimarron_Interch\\Utilities\\Drawings\\Gas Site Plan

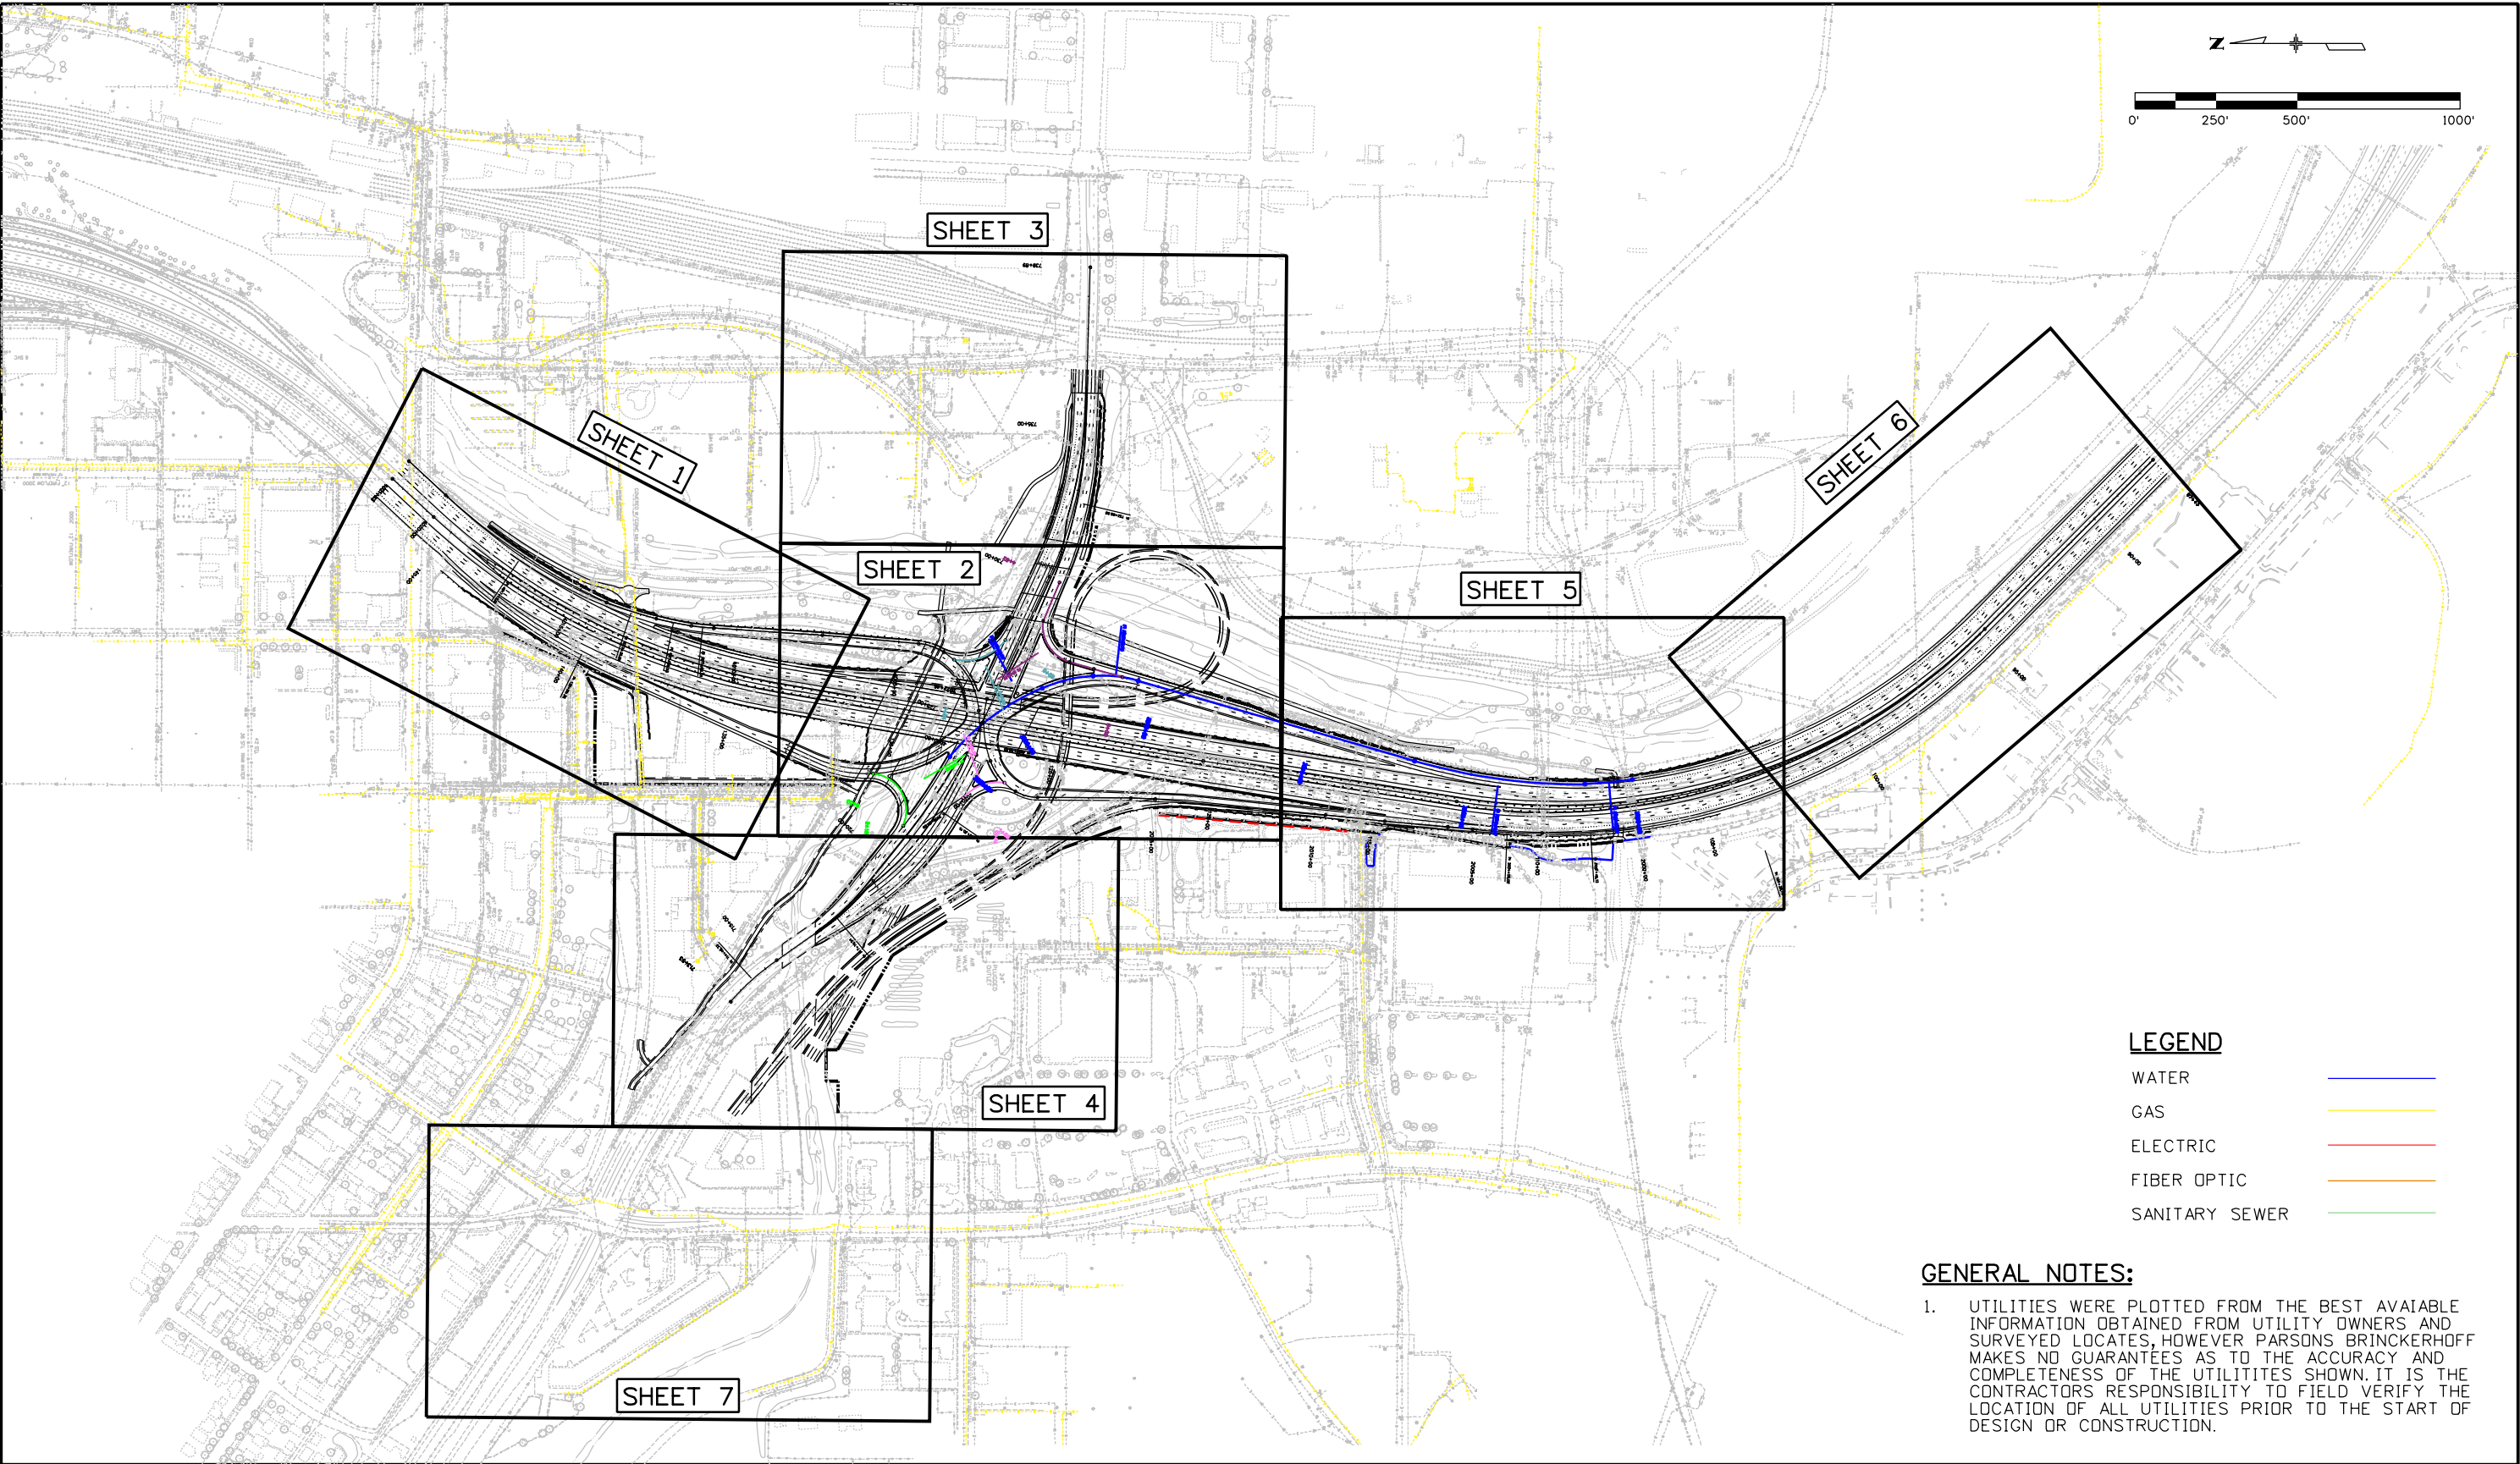

LEGEND


WATER	
GAS	
ELECTRIC	
FIBER OPTIC	
SANITARY SEWER	

GENERAL NOTES:

- UTILITIES WERE PLOTTED FROM THE BEST AVAILABLE INFORMATION OBTAINED FROM UTILITY OWNERS AND SURVEYED LOCATES, HOWEVER PARSONS BRINCKERHOFF MAKES NO GUARANTEES AS TO THE ACCURACY AND COMPLETENESS OF THE UTILITIES SHOWN. IT IS THE CONTRACTORS RESPONSIBILITY TO FIELD VERIFY THE LOCATION OF ALL UTILITIES PRIOR TO THE START OF DESIGN OR CONSTRUCTION.

Print Date: 4/17/2014		Sheet Revisions			Colorado Department of Transportation		As Constructed		UTILITY GAS SITE PLAN		Project No./Code	
File Name: Gas Site Plan		Date:	Comments	Init.	 1480 Quail Lake Loop, Suite A Colorado Springs, CO 80906 Phone: 719-634-2323 FAX: 719-227-3298 Region 2 DMW		No Revisions:		Designer: XXXXXXXX		XXXXXX422X	
Horiz. Scale: 1:500 Vert. Scale:							Revised:		Detailer: XXXXXXXX		XXXXXX	
Unit Information Unit Leader Initials							Void:		Subset: _SG		Sheet Number _ON	
555 17th Street Suite 500 Denver, CO 80202									Structure Numbers			
									Subset Sheets: _SN of _SD			

PadillaK 1:42:32 PM pw:\ABQPWINT01\wilsonco.com\Wilson_Projects\Documents\8100-TRN\CDOT\13-100-312-01_125_Cimarron_Interch\19039\Utilities\Drawings\Gas Sheet 1

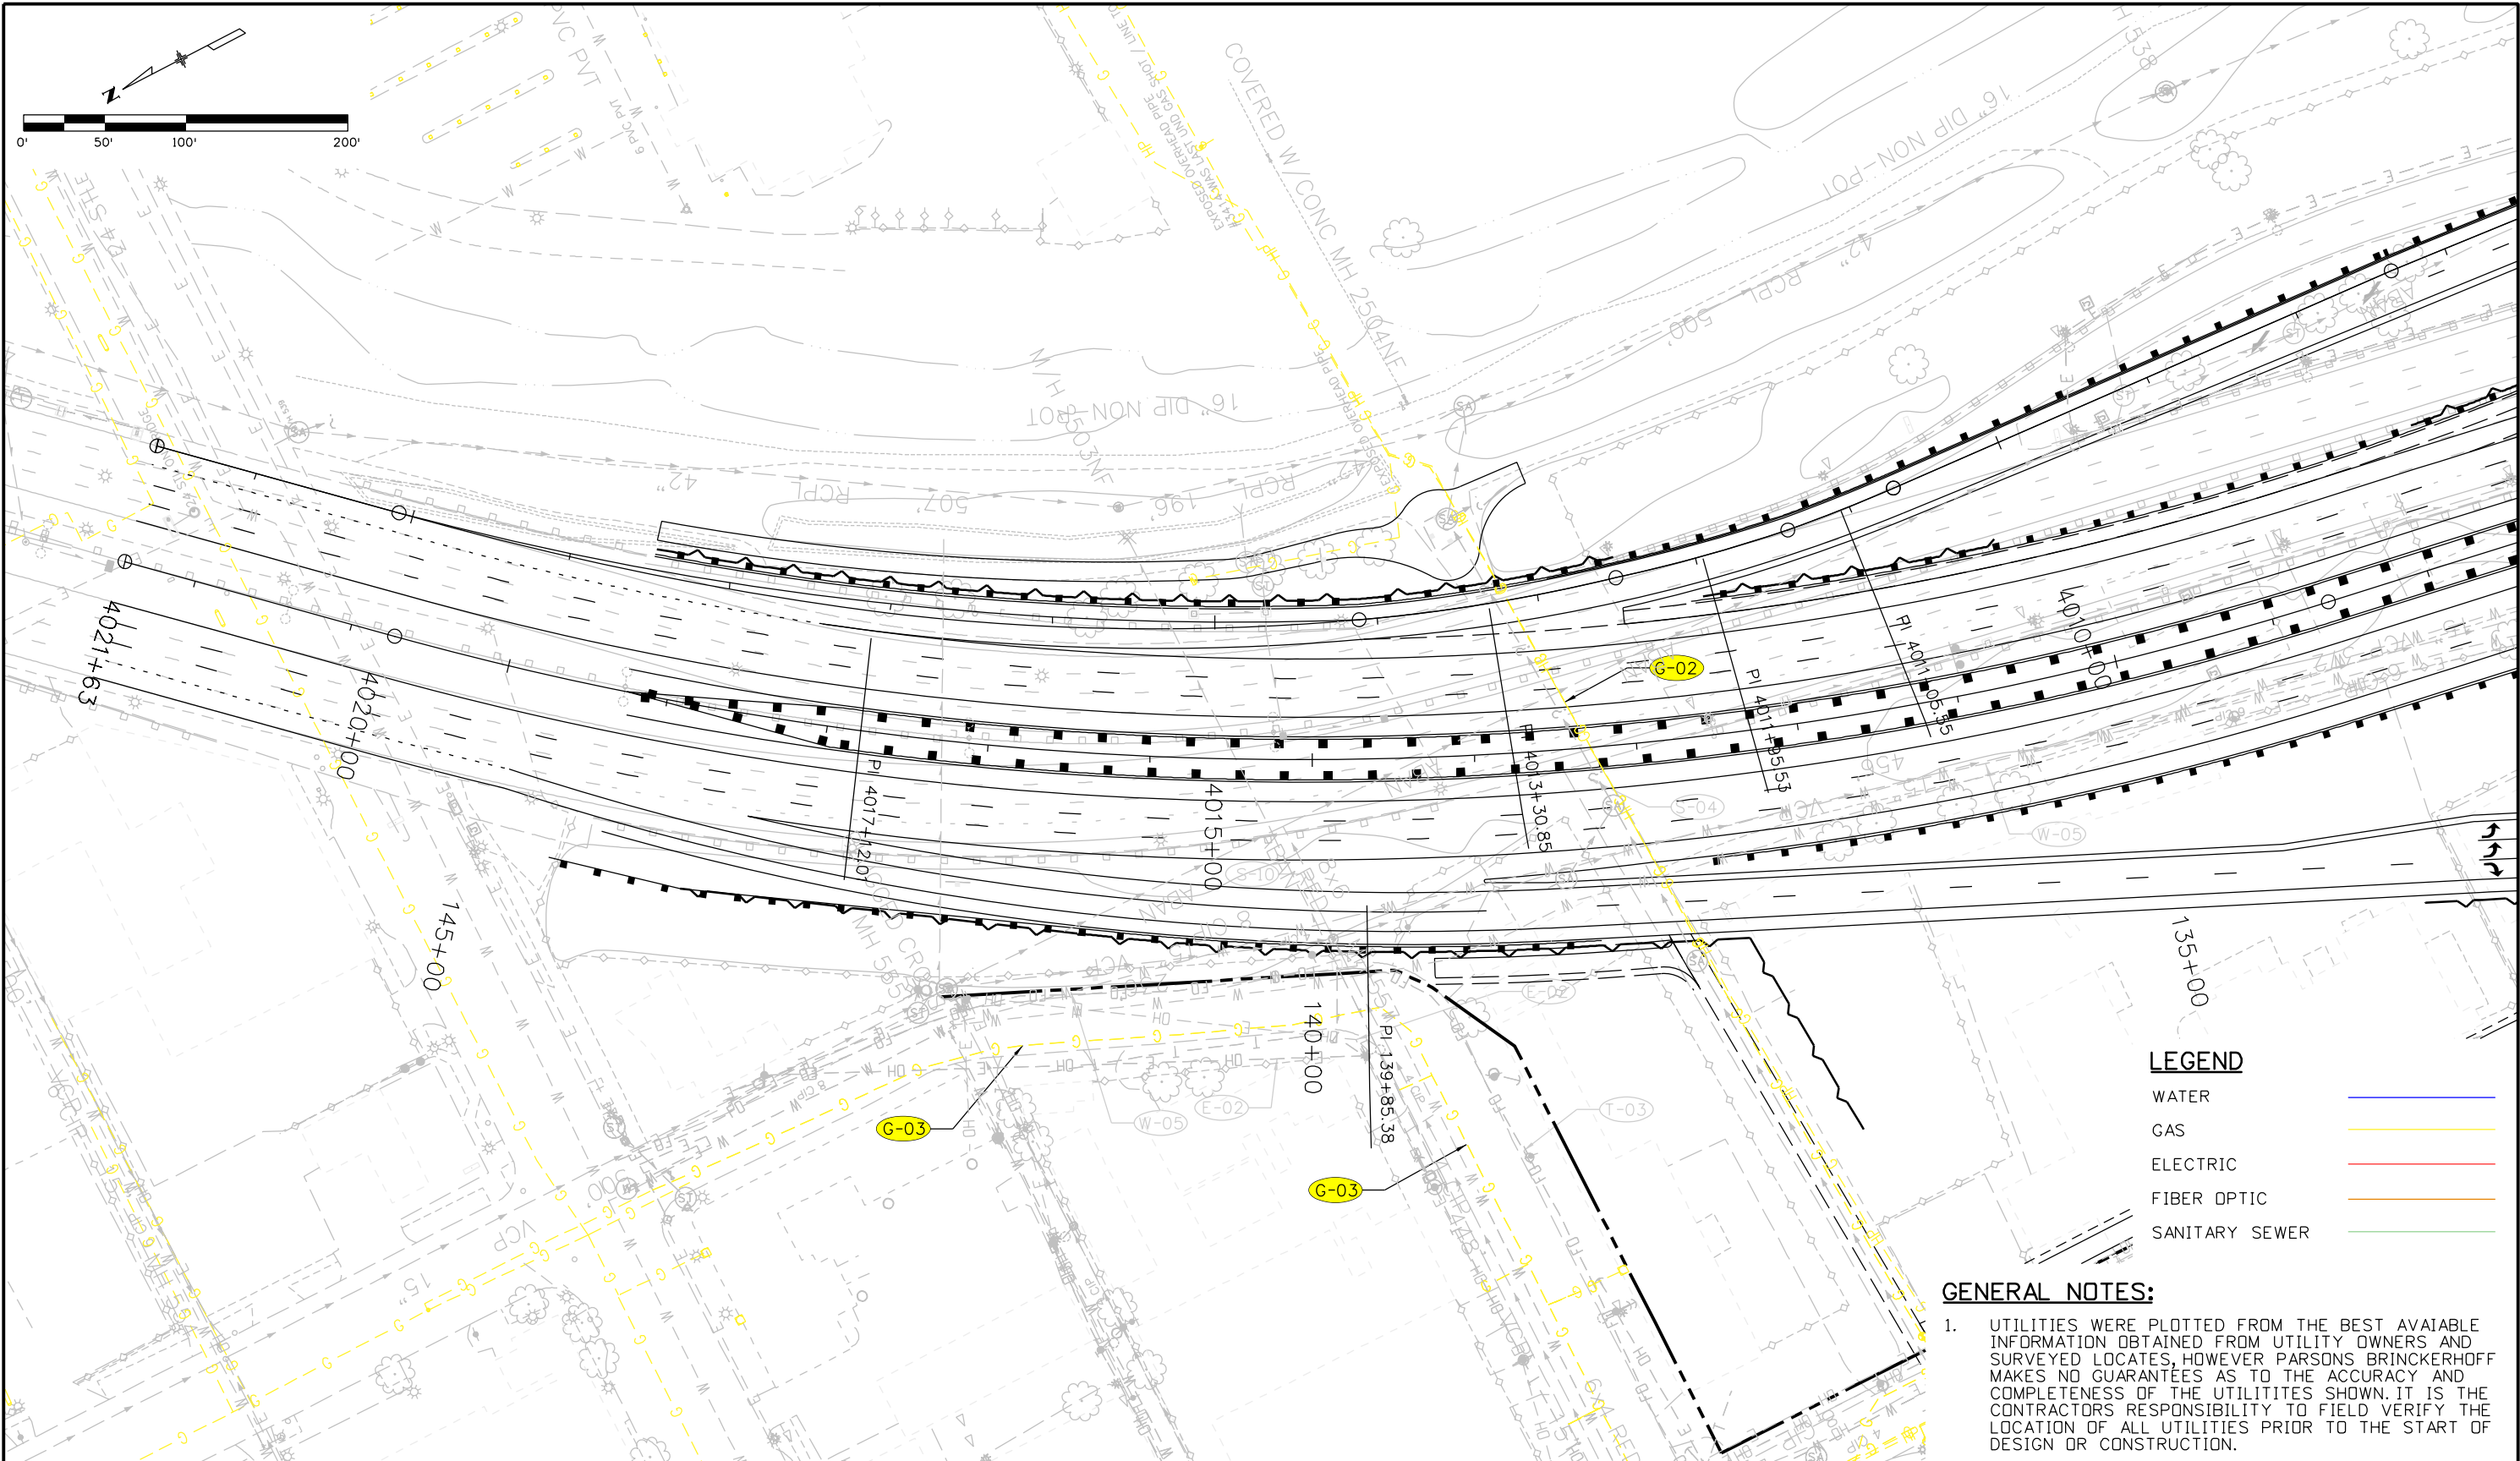


LEGEND


WATER	
GAS	
ELECTRIC	
FIBER OPTIC	
SANITARY SEWER	

GENERAL NOTES:

1. UTILITIES WERE PLOTTED FROM THE BEST AVAILABLE INFORMATION OBTAINED FROM UTILITY OWNERS AND SURVEYED LOCATES, HOWEVER PARSONS BRINCKERHOFF MAKES NO GUARANTEES AS TO THE ACCURACY AND COMPLETENESS OF THE UTILITIES SHOWN. IT IS THE CONTRACTORS RESPONSIBILITY TO FIELD VERIFY THE LOCATION OF ALL UTILITIES PRIOR TO THE START OF DESIGN OR CONSTRUCTION.

Print Date: 4/17/2014		<div><div>R-X</div><div></div><div></div><div></div><div></div></div>	Sheet Revisions			Colorado Department of Transportation		As Constructed		GAS SHEET 1 OF 7			Project No./Code	
File Name: Gas Sheet 1			Date:	Comments	Init.			No Revisions:					IM 0252-423	
Horiz. Scale: 1:100 Vert. Scale:						Revised:		Designer: XXXXXXXXX	Structure Numbers	19039				
Unit Information Unit Leader Initials						Void:		Detailer: XXXXXXXXX		Sheet Number _ON				
<div><div>PARSONS BRINCKERHOFF</div><div>555 17th Street Suite 500 Denver, CO 80202</div></div>						<div><div><div>1480 Quail Lake Loop, Suite A Colorado Springs, CO 80906 Phone: 719-634-2323 FAX: 719-227-3298</div></div><div>Region 2 DMW</div></div>				Subset: _SG	Subset Sheets: _SN of _SD			

PadillaK 1:46:14 PM pw:\ABQPWINT01\wilsonco.com\Wilson_P\Projects\Documents\8100-TRN\CDOT\13-100-312-01_125_Cimarron_Interch\Drawings\Gas Sheet 3

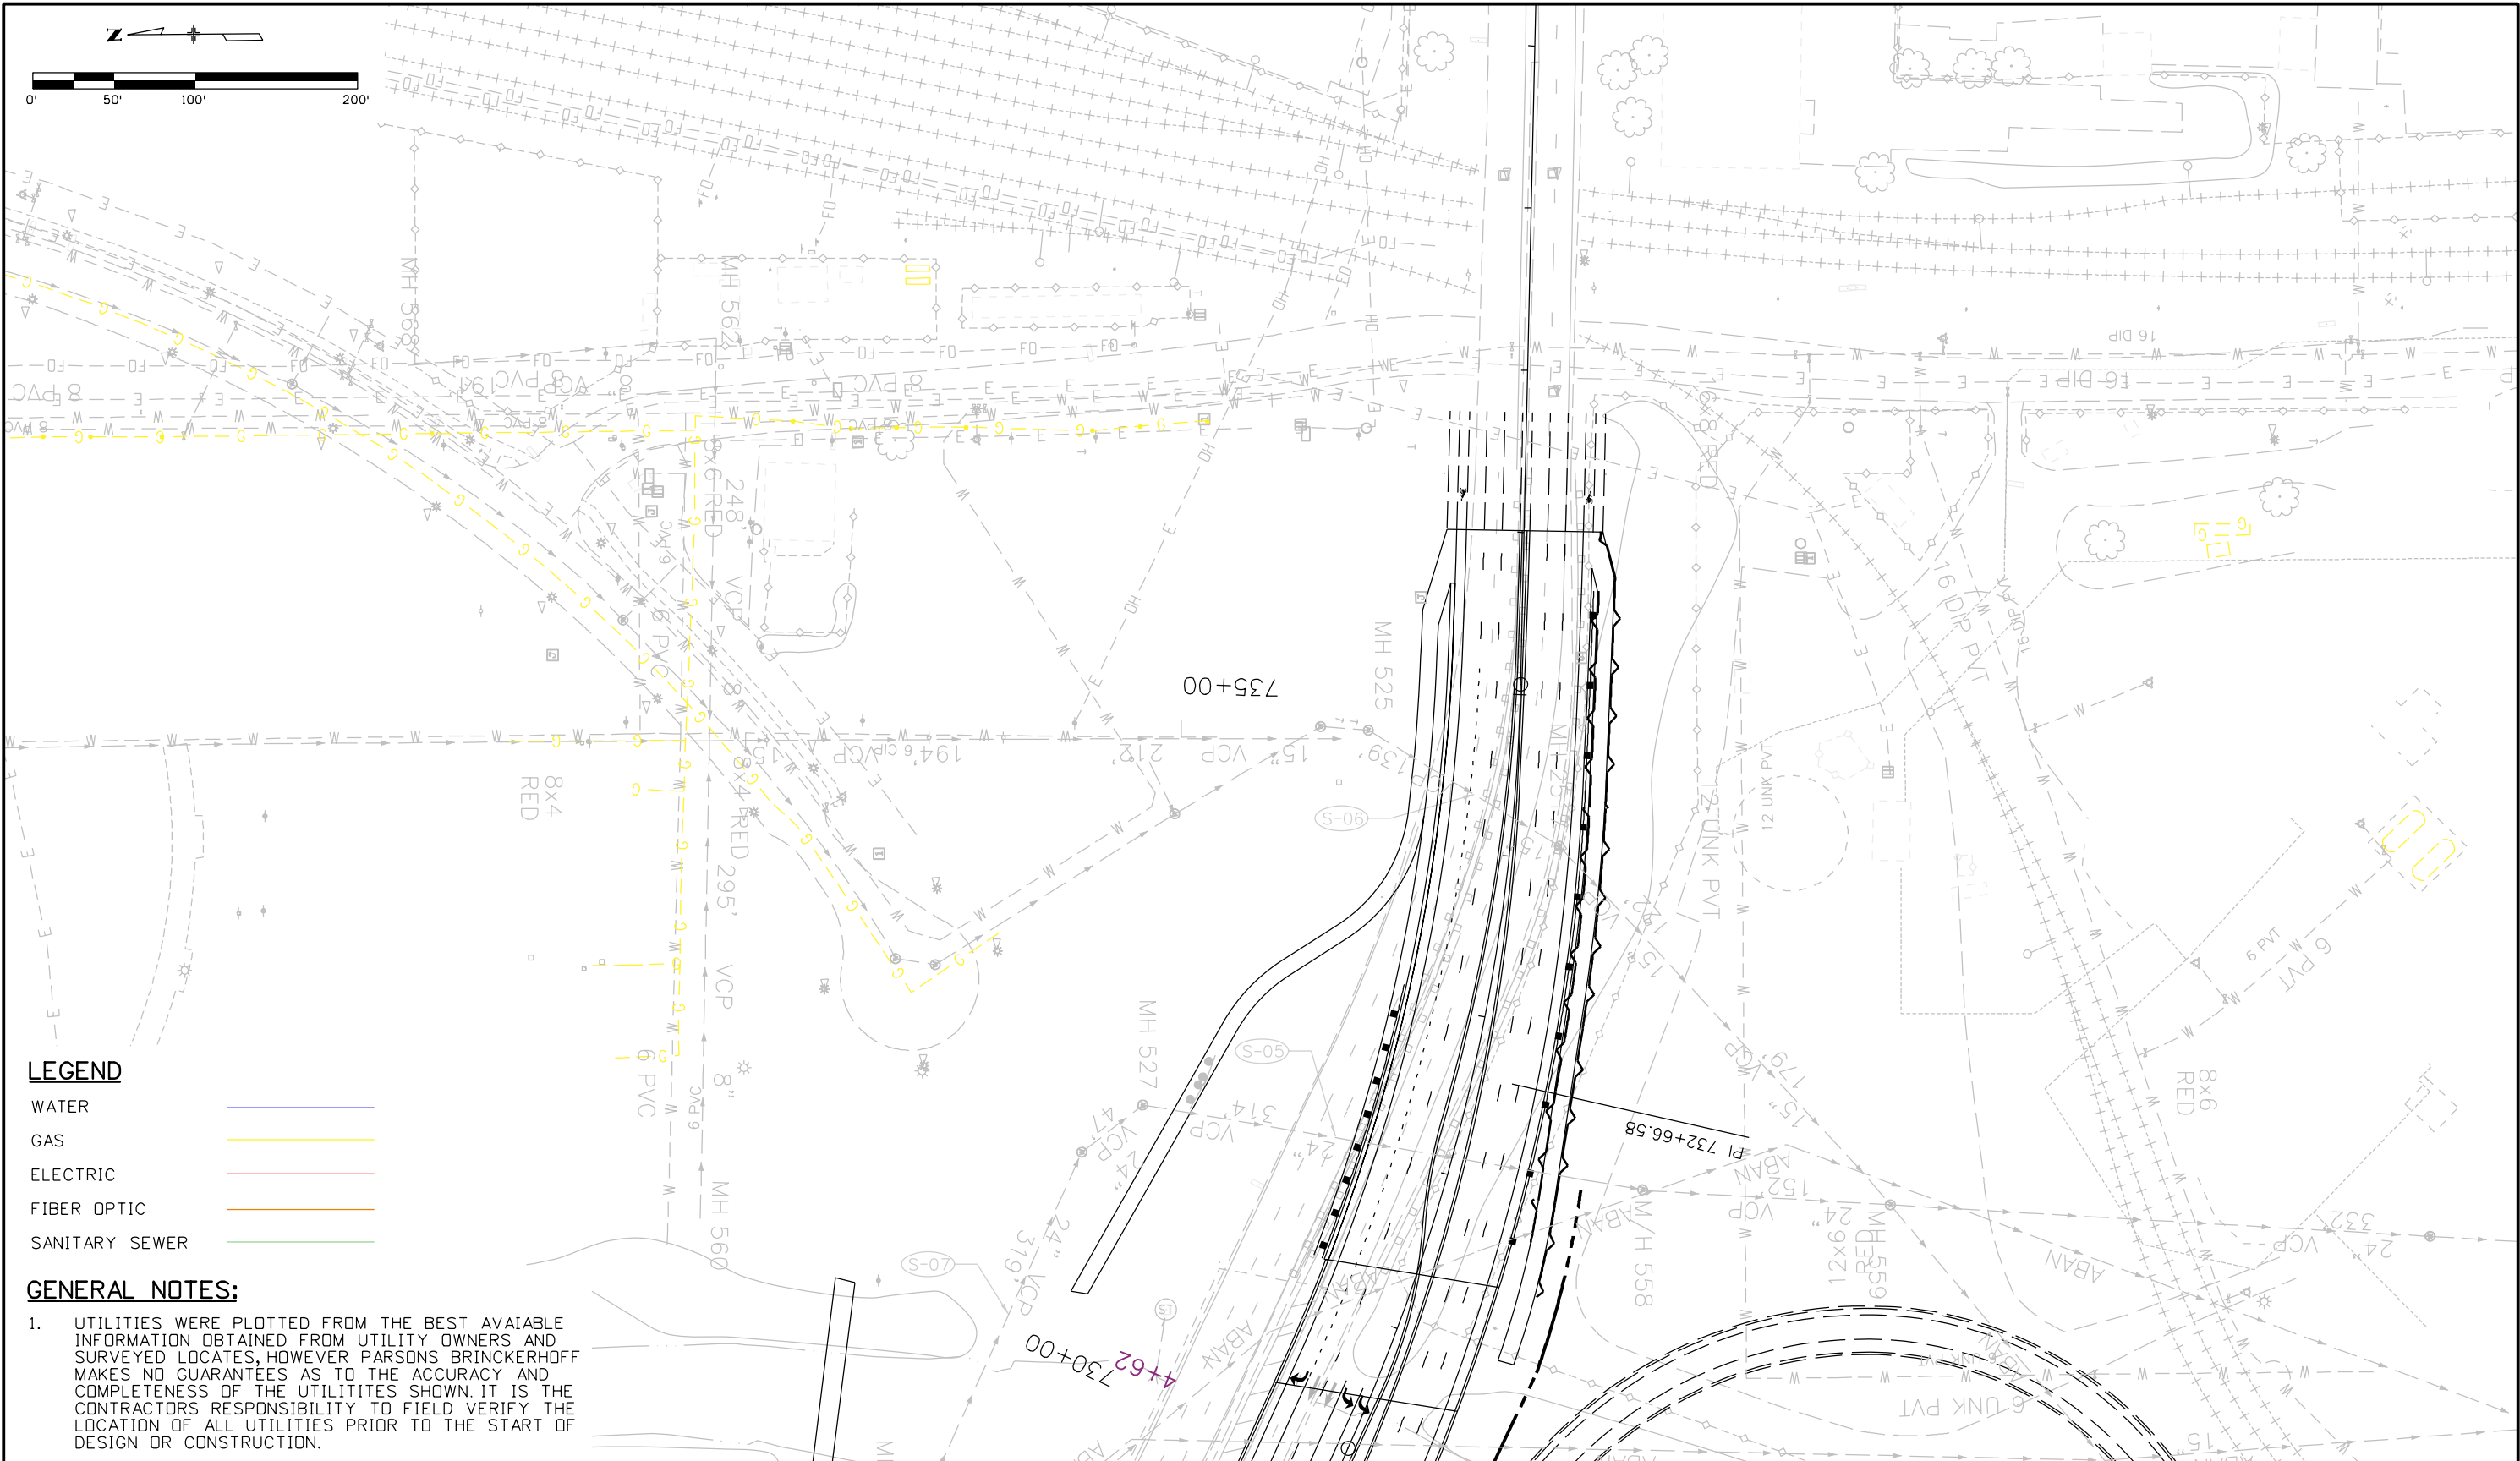


LEGEND


WATER	
GAS	
ELECTRIC	
FIBER OPTIC	
SANITARY SEWER	


GENERAL NOTES:

1. UTILITIES WERE PLOTTED FROM THE BEST AVAILABLE INFORMATION OBTAINED FROM UTILITY OWNERS AND SURVEYED LOCATES, HOWEVER PARSONS BRINCKERHOFF MAKES NO GUARANTEES AS TO THE ACCURACY AND COMPLETENESS OF THE UTILITIES SHOWN. IT IS THE CONTRACTORS RESPONSIBILITY TO FIELD VERIFY THE LOCATION OF ALL UTILITIES PRIOR TO THE START OF DESIGN OR CONSTRUCTION.

Print Date: 4/17/2014		<div><div></div><div></div><div></div><div></div><div></div><div></div></div>	Sheet Revisions			Colorado Department of Transportation		As Constructed		GAS SHEET 3 OF 7				Project No./Code	
File Name: Gas Sheet 3			Date:	Comments	Init.	<div> 1480 Quail Lake Loop, Suite A Colorado Springs, CO 80906 Phone: 719-634-2323 FAX: 719-227-3298 Region 2 DMW</div>	No Revisions:		IM 0252-423				IM 0252-423		
Horiz. Scale: 1:100 Vert. Scale:							Revised:						Designer: XXXXXXXX Structure		
Unit Information Unit Leader Initials							Void:		Detailer: XXXXXXXX Numbers						
<div><div>PARSONS BRINCKERHOFF</div><div>555 17th Street Suite 500 Denver, CO 80202</div></div>									Subset: _SG Subset Sheets: _SN of _SD						
										19039		Sheet Number _ON			

PadillaK 1:47:39 PM pw:\ABOPWINT01.wilsonco.com\Wilson_Projcts\Documents\8100-TRN\CDOT\13-100-312-01_125_Cimarron_Interch\19039\Utilities\Drawings\Gas Sheet 4

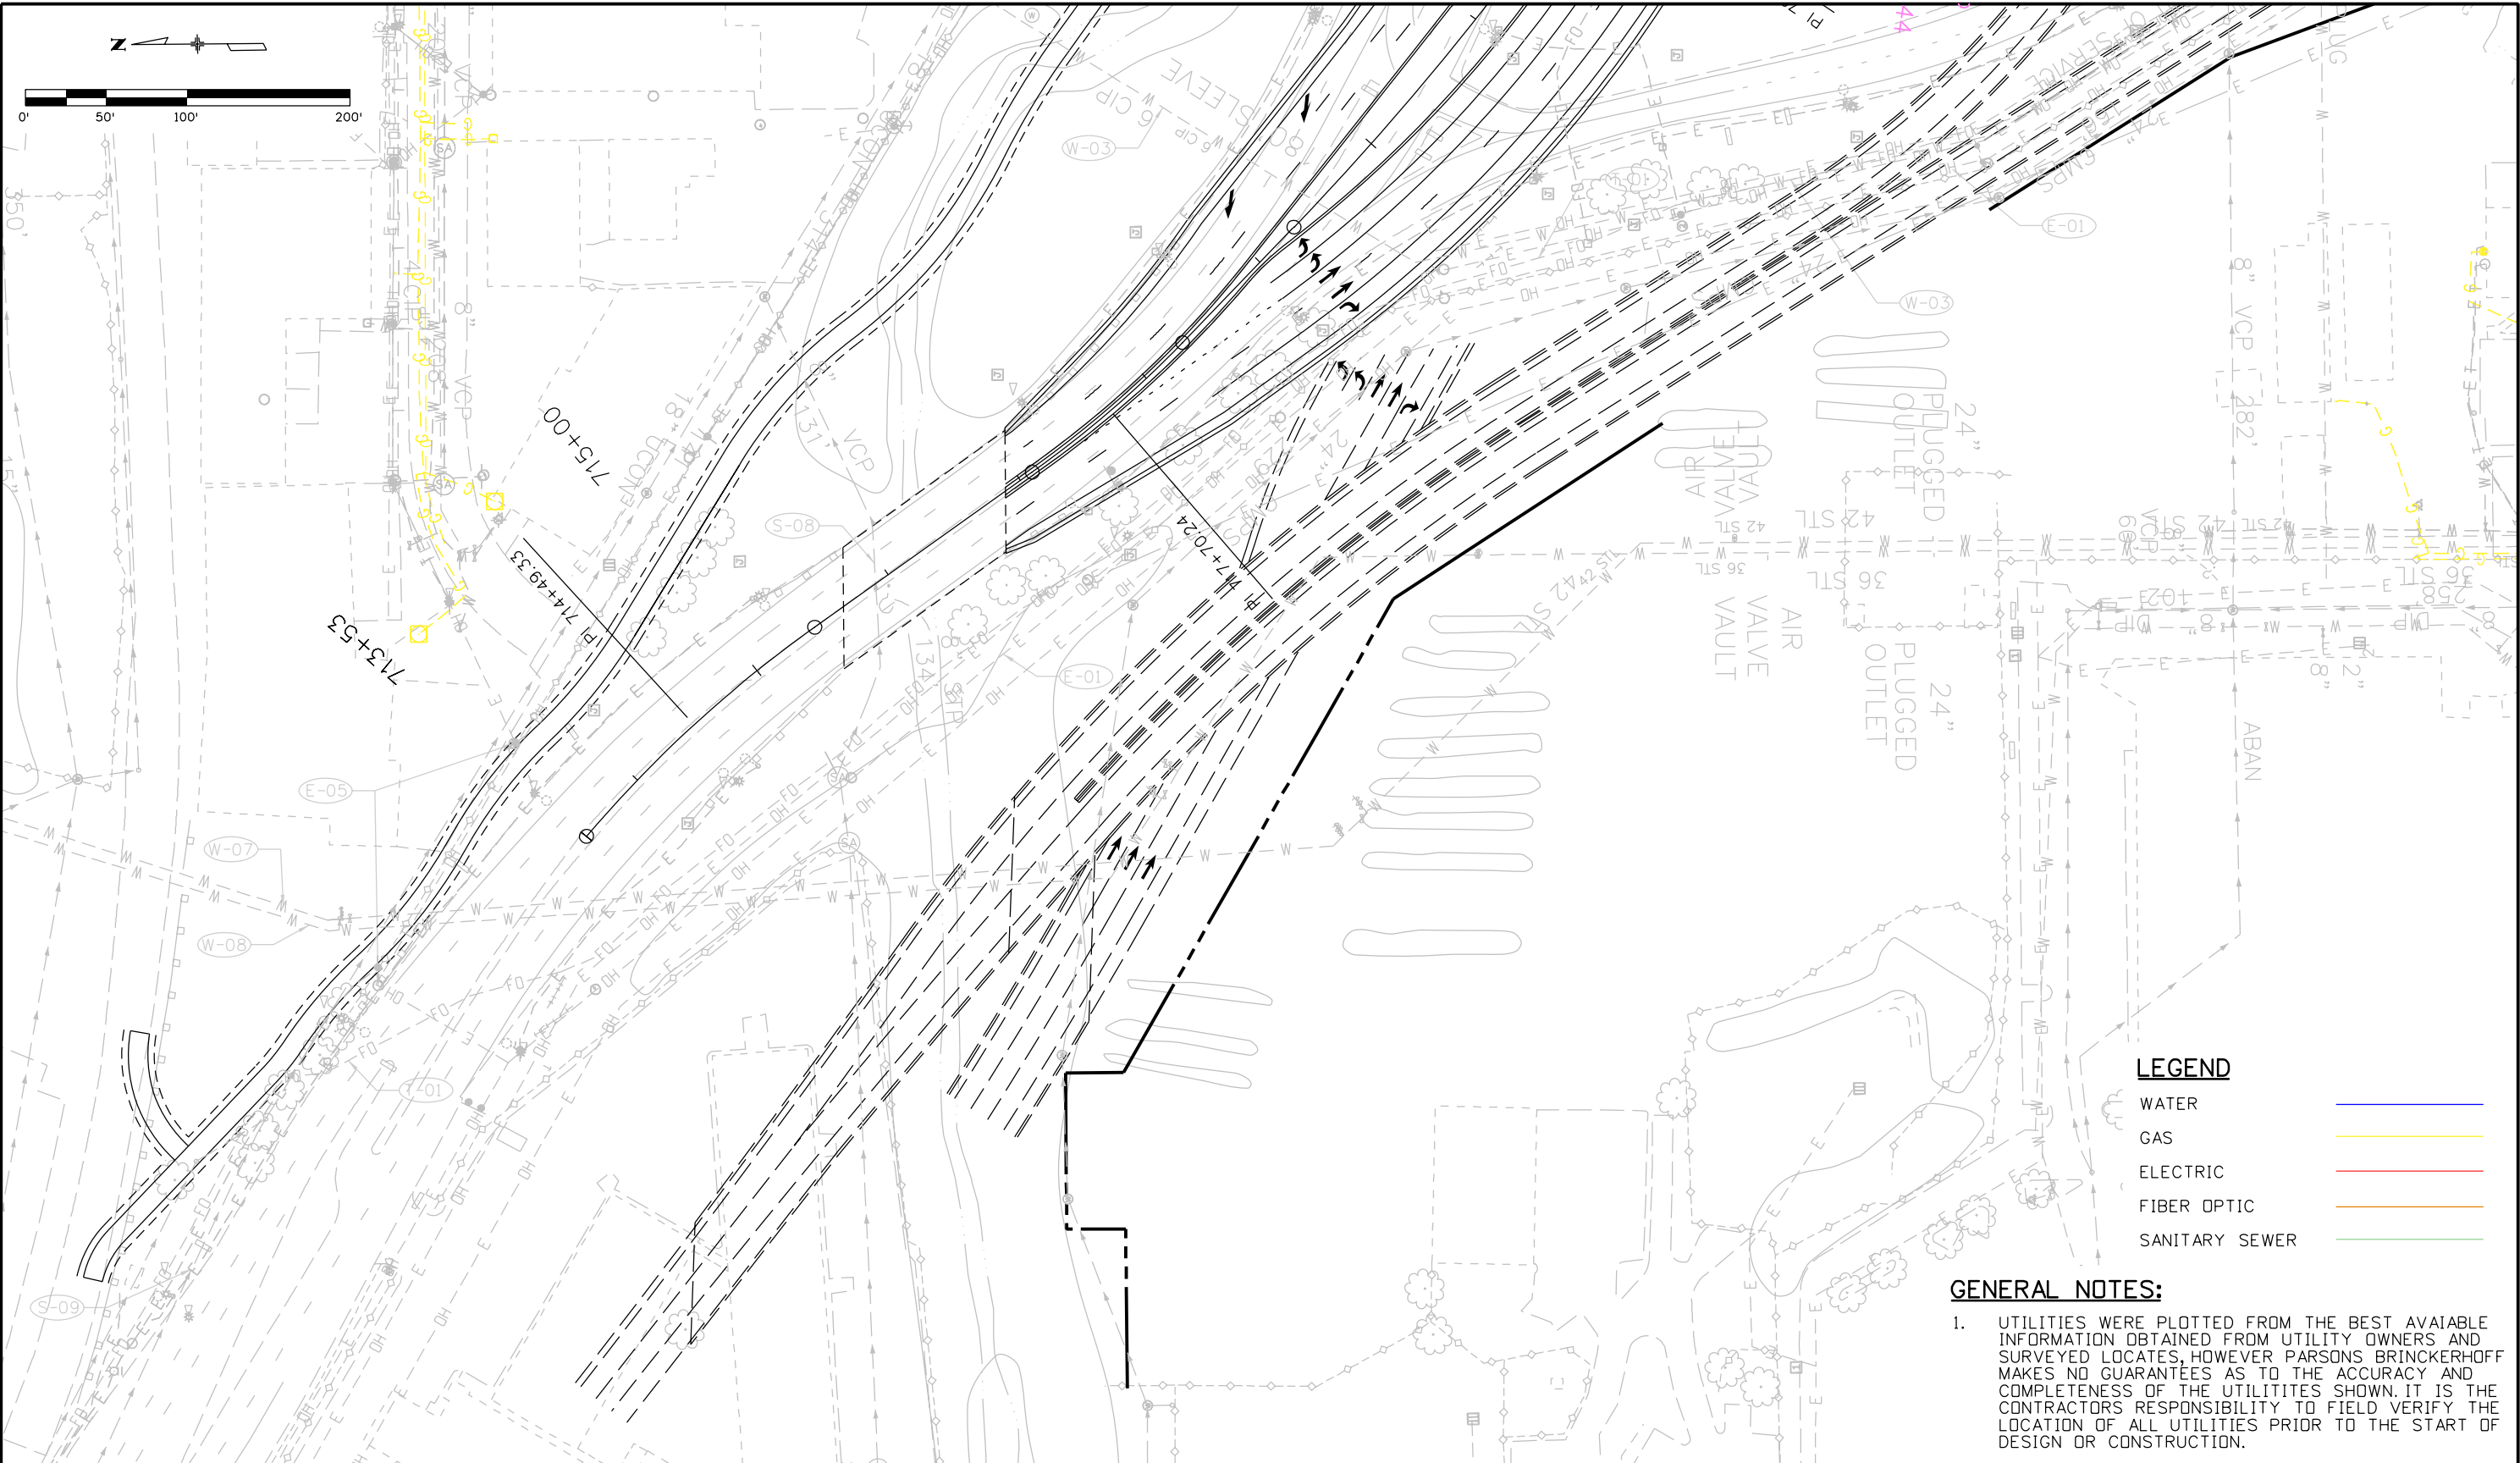


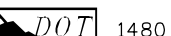Print Date: 4/17/2014		<div><div></div><div></div><div></div><div></div><div></div></div>	Sheet Revisions			<div>Colorado Department of Transportation</div> <div><div>1480 Quail Lake Loop, Suite A Colorado Springs, CO 80906 Phone: 719-634-2323 FAX: 719-227-3298</div></div> <div>Region 2</div> <div>DMW</div>	As Constructed		GAS SHEET 4 OF 7				Project No./Code	
File Name: Gas Sheet 4			Date:	Comments	Init.		No Revisions:		IM 0252-423					
Horiz. Scale: 1:100							Revised:		Designer: XXXXXXXX		Structure		19039	
Unit Information							Void:		Detailer: XXXXXXXX		Numbers		Sheet Number	
Unit Leader Initials									Subset: _SG		Subset Sheets: _SN of _SD		_ON	
<div><div>PARSONS BRINCKERHOFF</div><div>555 17th Street Suite 500 Denver, CO 80202</div></div>														


Print Date: 4/17/2014		<div>R-X</div> <div></div> <div></div> <div></div>	Sheet Revisions			<div>Colorado Department of Transportation</div> <div><div><div><div></div><div></div><div></div></div><div>DOT</div><div>DEPARTMENT OF TRANSPORTATION</div></div><div>1480 Quail Lake Loop, Suite A Colorado Springs, CO 80906 Phone: 719-634-2323 FAX: 719-227-3298</div></div> <div>Region 2</div> <div>DMW</div>		As Constructed		GAS SHEET 5 OF 7			Project No./Code		
File Name: Gas Sheet 5			Date:					Init.					IM 0252-423		
Horiz. Scale: 1:100			Vert. Scale:												
Unit Information			Unit Leader Initials												
<div>PARSONS BRINCKERHOFF</div> <div>555 17th Street Suite 500 Denver, CO 80202</div>															
								No Revisions:							
								Revised:		Designer: XXXXXXXX		Structure			
										Detailer: XXXXXXXX		Numbers			
								Void:		Subset: _SG		Subset Sheets: _SN of _SD		Sheet Number _ON	

Print Date: 4/17/2014		<div><div>R-X</div><div></div><div></div><div></div></div>	Sheet Revisions			<div><div><div><div><div></div><div></div></div><div>DOT</div><div>DEPARTMENT OF TRANSPORTATION</div></div><div><div>Colorado Department of Transportation</div><div><div>1480 Quail Lake Loop, Suite A</div><div>Colorado Springs, CO 80906</div><div>Phone: 719-634-2323 FAX: 719-227-3298</div></div><div><div>Region 2</div><div>DMW</div></div></div></div></div>			As Constructed		GAS SHEET 6 OF 7				Project No./Code		
File Name: Gas Sheet 6			Date:		Comments				Init.						No Revisions:		IM 0252-423
Horiz. Scale: 1:100			Vert. Scale:										19039				
Unit Information			Unit Leader Initials										Detailer: XXXXXXXX		Structure Numbers		
<div><div><div>PARSONS</div><div>BRINCKERHOFF</div></div><div>555 17th Street Suite 500 Denver, CO 80202</div></div>													Revised:		Subset: _SG		Subset Sheets: _SN of _SD
										Void:							

PadillaK 1:57:22 PM pw:\ABQPWINT01.wilsonco.com\Wilson_Projects\Documents\8100-TRN\CDOT\13-100-312-01_125_Cimarron_Interch\19039\Utilities\Drawings\Gas Sheet 7

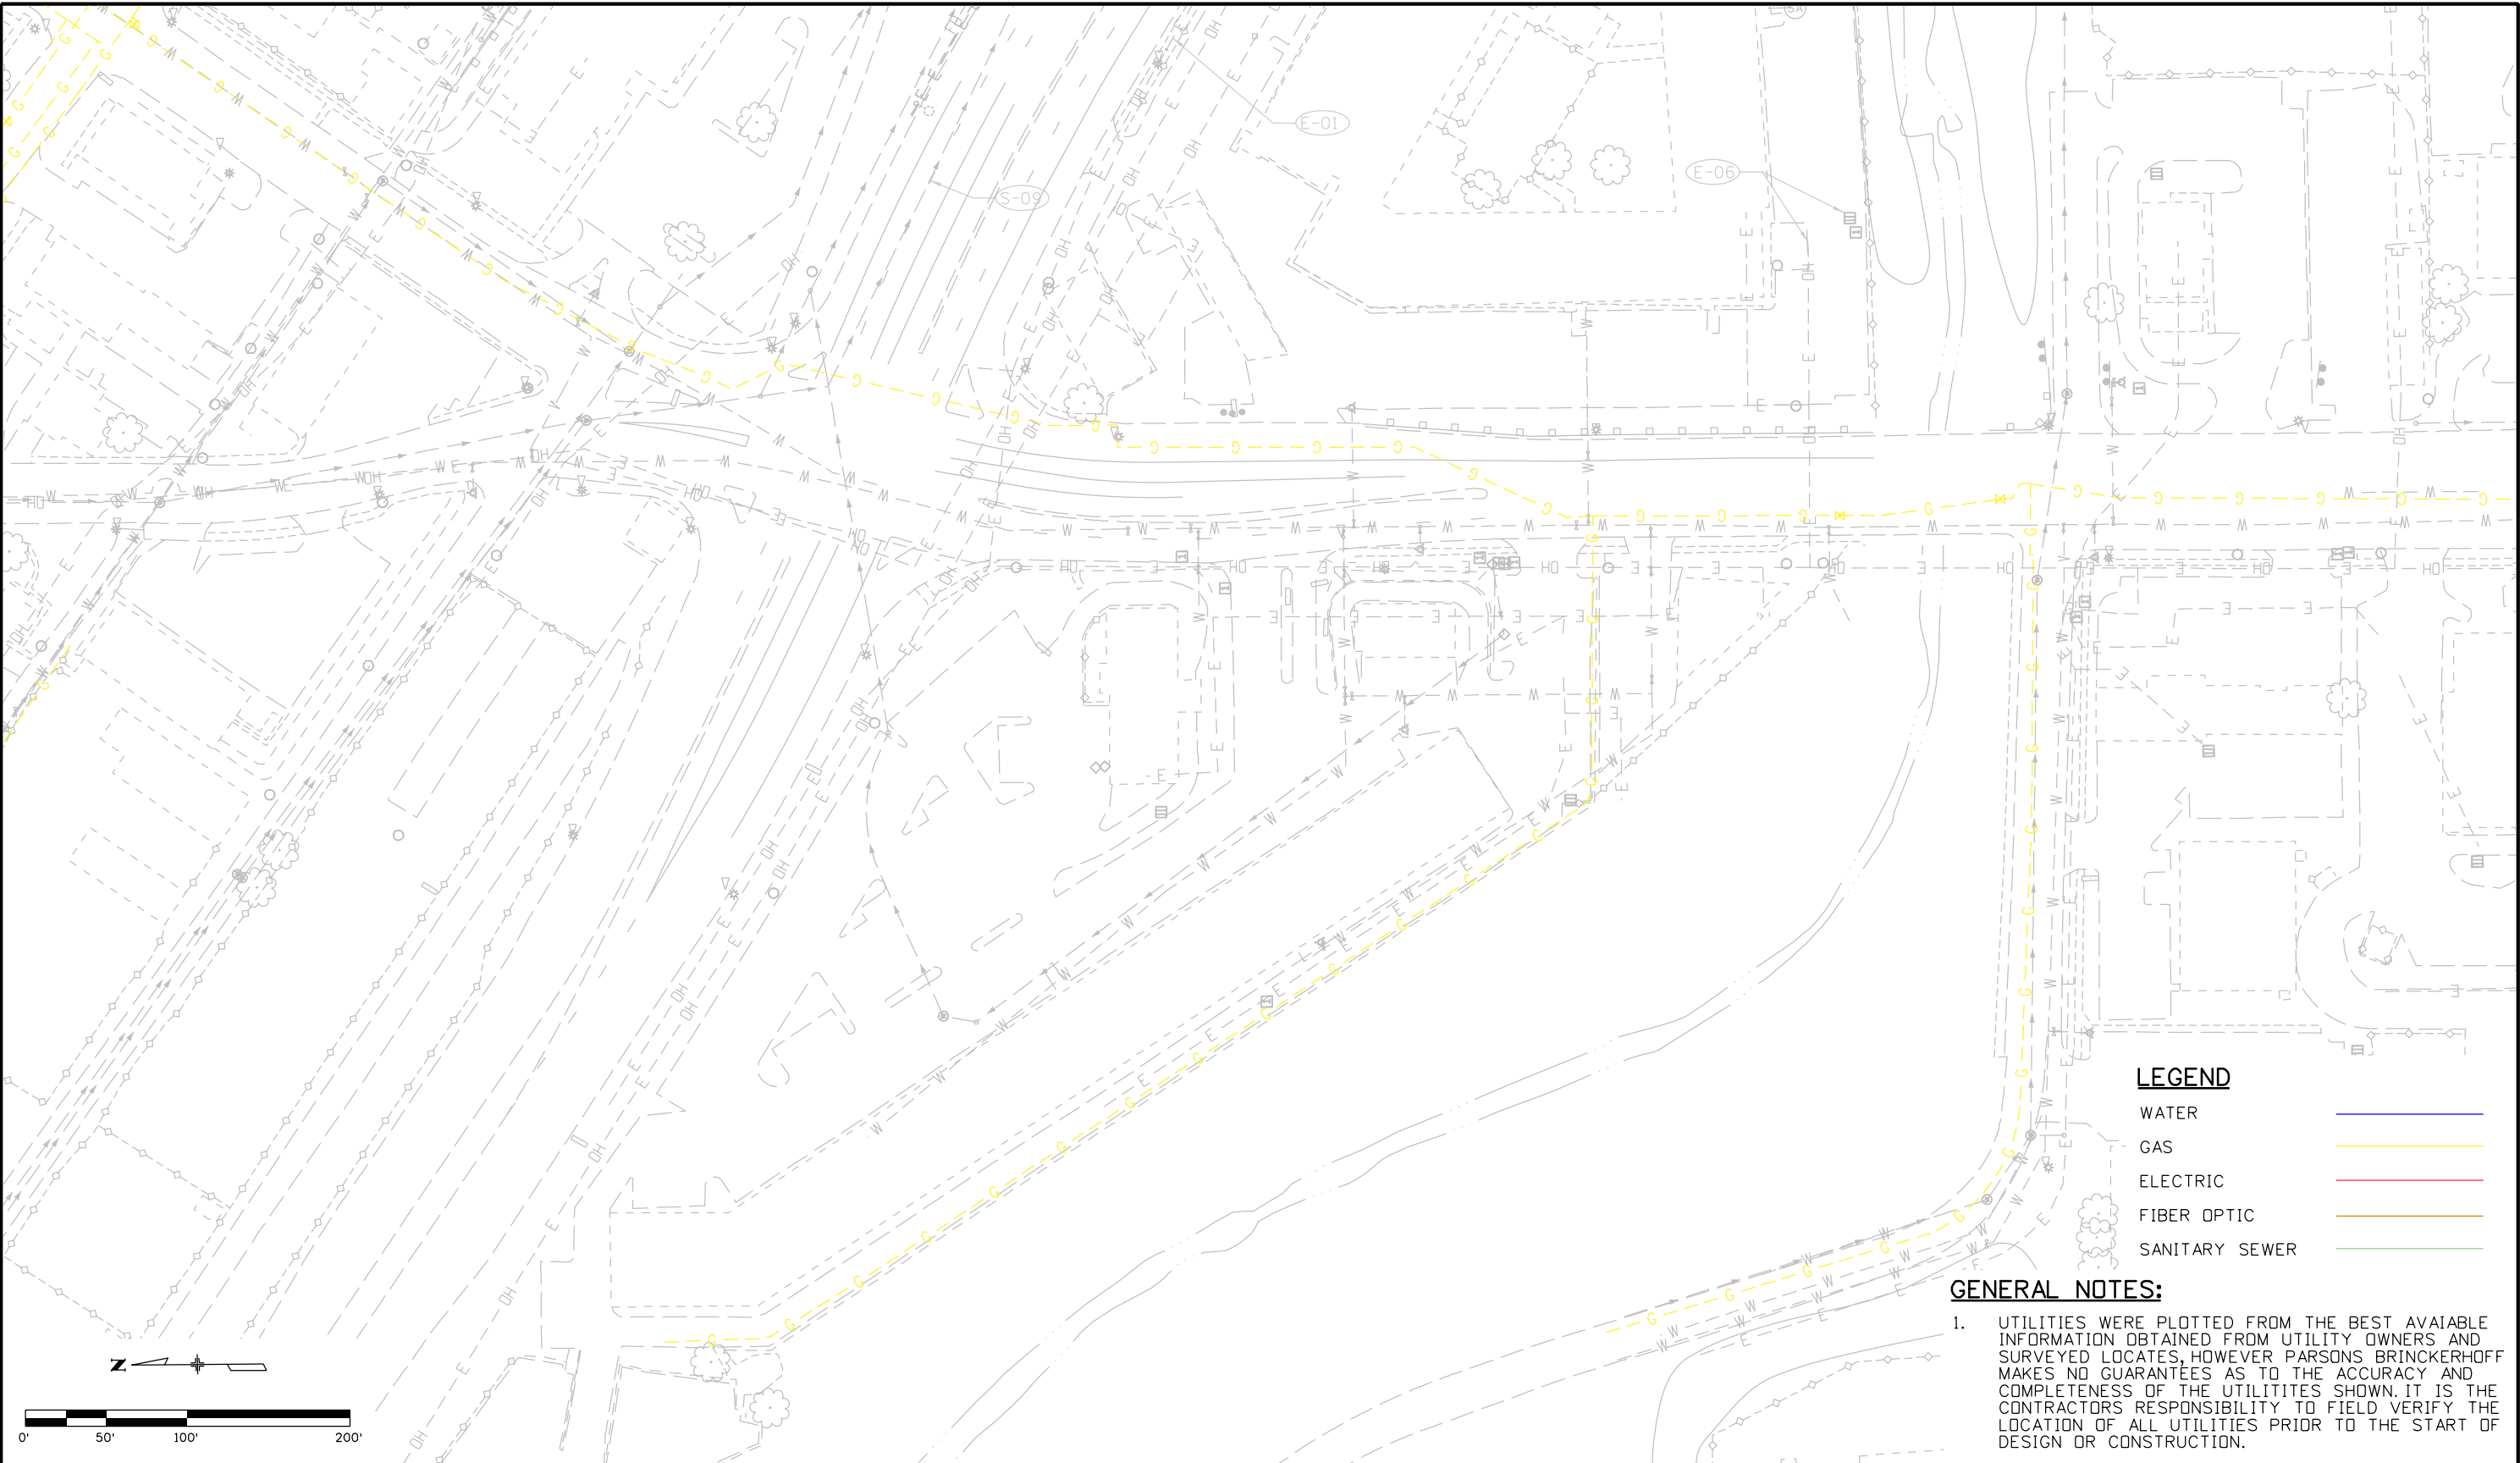

- GENERAL NOTES:**
1. UTILITIES WERE PLOTTED FROM THE BEST AVAILABLE INFORMATION OBTAINED FROM UTILITY OWNERS AND SURVEYED LOCATES, HOWEVER PARSONS BRINCKERHOFF MAKES NO GUARANTEES AS TO THE ACCURACY AND COMPLETENESS OF THE UTILITIES SHOWN. IT IS THE CONTRACTORS RESPONSIBILITY TO FIELD VERIFY THE LOCATION OF ALL UTILITIES PRIOR TO THE START OF DESIGN OR CONSTRUCTION.

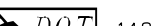Print Date: 4/17/2014		<div><div>R-X</div><div></div><div></div><div></div></div>	Sheet Revisions			Colorado Department of Transportation			As Constructed		GAS SHEET 7 OF 7			Project No./Code	
File Name: Gas Sheet 7			Date:	Comments	Init.	<div><div>1480 Quail Lake Loop, Suite A Colorado Springs, CO 80906 Phone: 719-634-2323 FAX: 719-227-3298</div><div>Region 2DMW</div></div>			No Revisions:		Designer: XXXXXXXX Detailer: XXXXXXXX Subset: _SG			IM 0252-423	
Horiz. Scale: 1:100 Vert. Scale:															
Unit Information Unit Leader Initials															
<div><div>PARSONS BRINCKERHOFF</div><div>555 17th Street Suite 500 Denver, CO 80202</div></div>															
								Revised:		Structure Numbers		19039			
								Void:		Subset Sheets: _SN of _SD		Sheet Number _ON			